
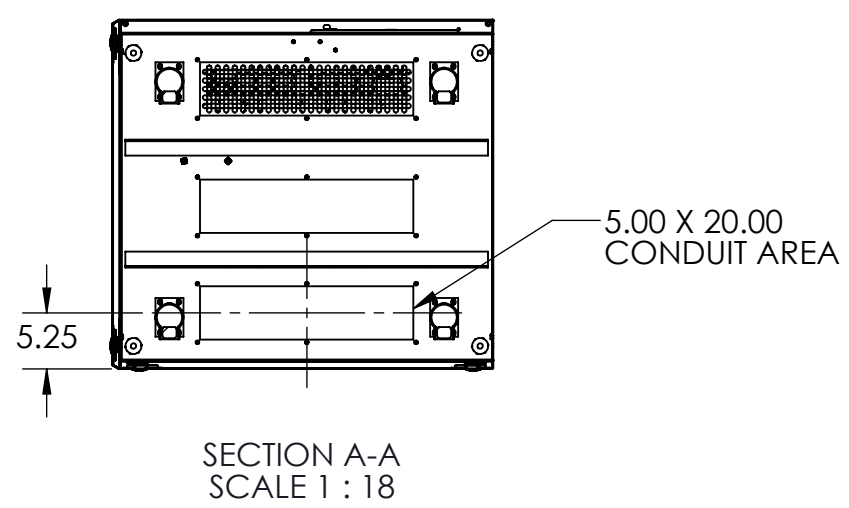
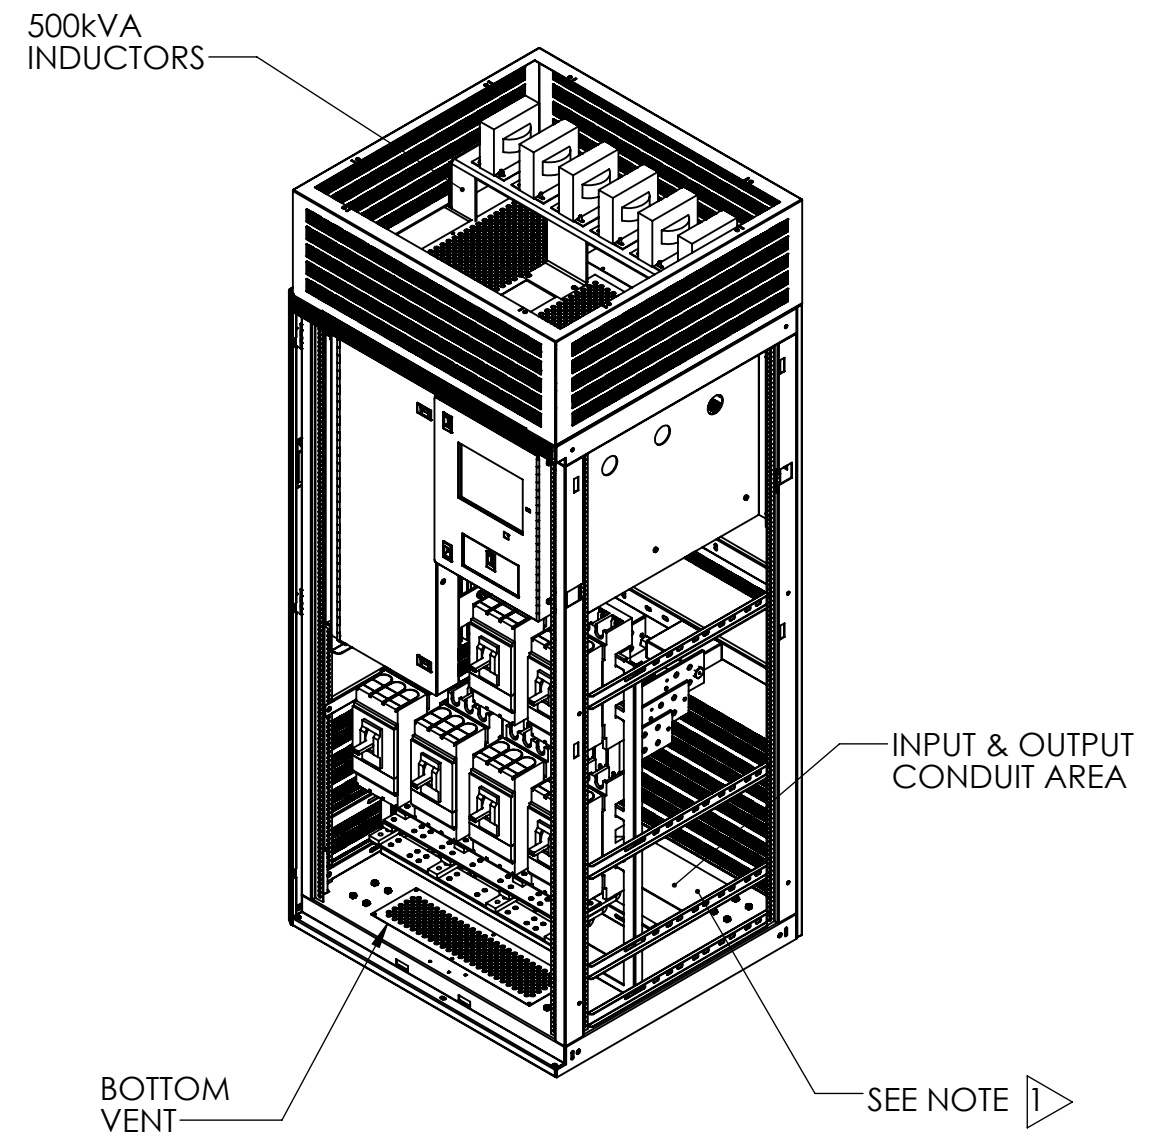
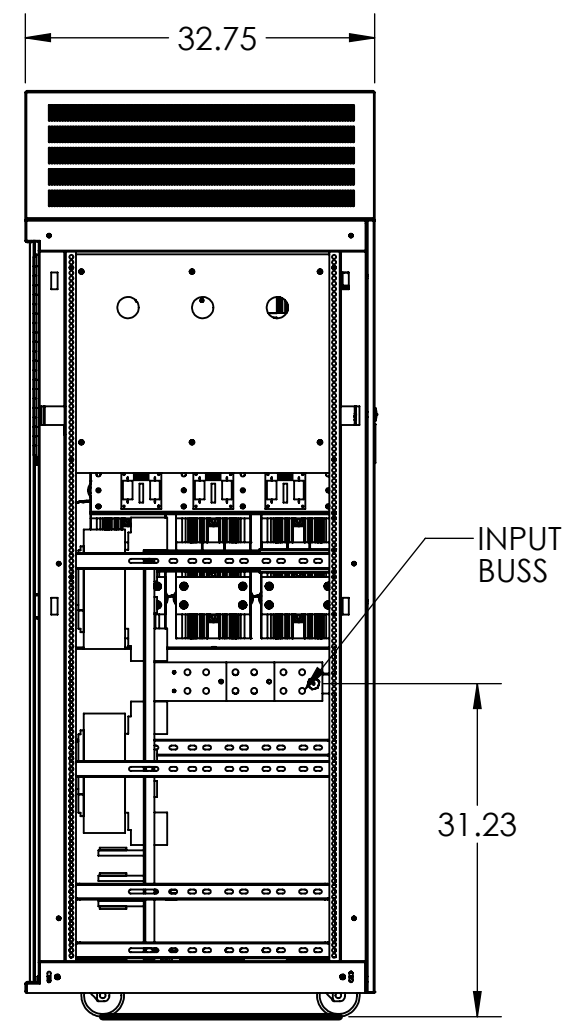


8 7 6 5 4 3 2 1

D
C
B
A

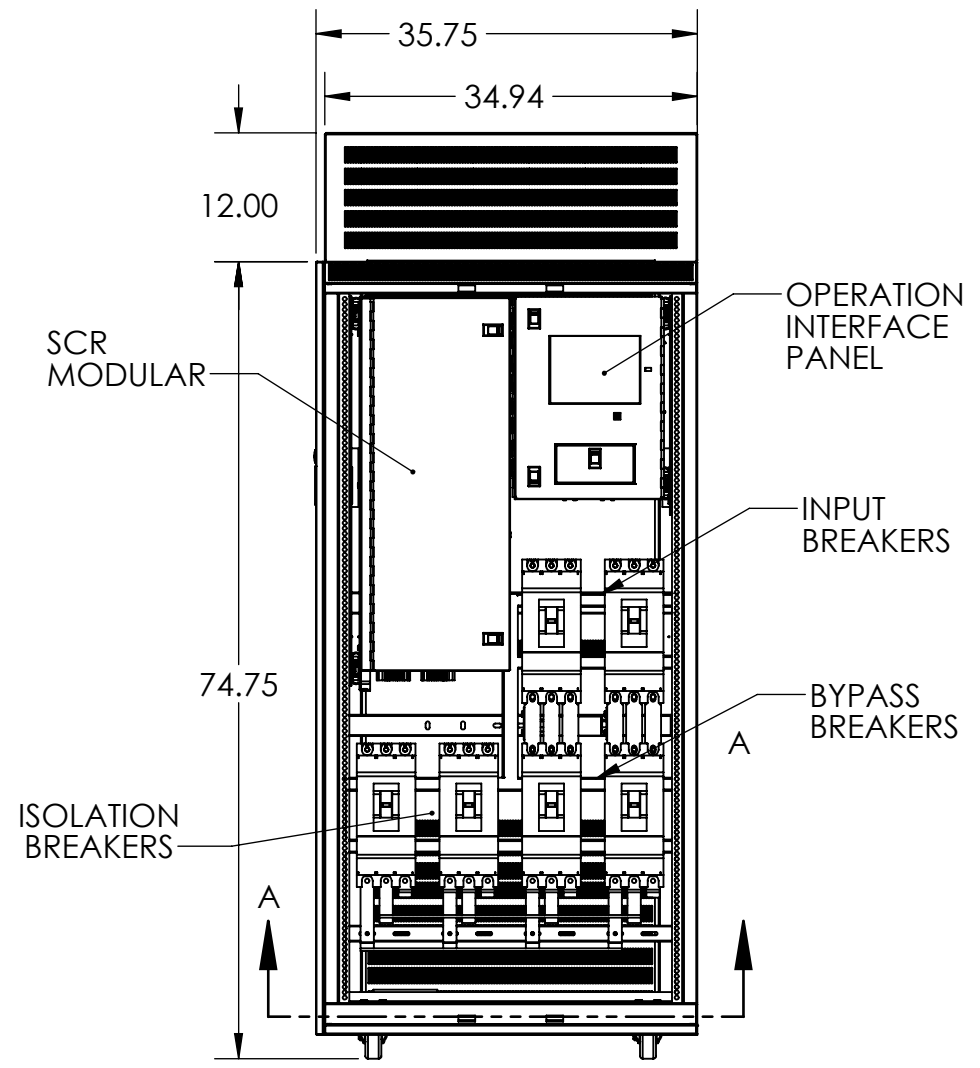

NOTES:
AS BUILT FOR DATA FOUNDRY
PROVISION FOR CT 600:1, 4" WINDOW, PDI P/N XMR17547

UNLESS OTHERWISE SPECIFIED: DIMENSIONS ARE IN INCHES [] IN MILLIMETER ANGULAR: ±0.5° BEND ±1° TWO PLACE DECIMAL ±0.02 THREE PLACE DECIMAL ±0.005		THIS DRAWING CONTAINS CONFIDENTIAL & PROPRIETARY INFORMATION AND SHALL NOT BE DISCLOSED OR COPIED WITHOUT THE EXPRESSED, WRITTEN PERMISSION OF SMITHS POWER		PDI
THIRD ANGLE PROJECTION		DO NOT SCALE DRAWING		
APPROVALS		DATE		SIZE
DRAWN	LJN	9/4/15		DWG. NO. STS-SO19818
CHECKED				REV
ENG. APPR.				PART NO.
				SHEET 1 OF 1

8 7 6 5 4 3 2 1